



Emily M. Farah
Counsel, Regulatory

411 Seventh Avenue
Mail drop 15-7
Pittsburgh, PA 15219

Tel: 412-393-6431
efarah@duqlight.com

June 21, 2019

VIA ELECTRONIC FILING

Rosemary Chiavetta, Secretary
Pennsylvania Public Utility Commission
Commonwealth Keystone Building, 2nd Floor
400 North Street
Harrisburg, PA 17120

Re: Municipal Contract - Right of Way Agreement between Duquesne Light Company and
the City of Pittsburgh- 11th Ward
Docket No. U-2019-_____

Dear Secretary Chiavetta:

Enclosed for review and approval in accordance with Section 507 of the Public Utility Code, 66 Pa.C.S. § 507 and 52 Pa. Code § 3.101, is a Right of Way agreement dated June 14, 2019 between Duquesne Light Company and the City of Pittsburgh. The City of Pittsburgh granted to Duquesne Light Company a right of way on its property situated on Washington Boulevard in the City of Pittsburgh, Allegheny County, which provides the right to erect, install, use, own, operate, maintain, repair, renew and remove an electrical line. No compensation was provided to the City of Pittsburgh.

Should you have any questions regarding the enclosed right of way, please contact Dan Antosik at 412-393-8628.

Respectfully Submitted,

A handwritten signature in blue ink, appearing to read "Emily M. Farah", is written over the typed name.

Emily M. Farah
Attorney ID#322559

Enclosures

478557 pole

**DUQUESNE LIGHT CO. COPY
RIGHT OF WAY AGREEMENT**


The undersigned Grantor, **CITY OF PITTSBURGH, a municipal corporation of the Commonwealth of Pennsylvania**, for good and valuable consideration, the receipt of which is hereby acknowledged **does hereby grant** unto Duquesne Light Company, its successors and assigns, for providing, transmitting and/or distributing electric and/or communications services for any and all purposes, the right, privilege and authority to erect, install, use, own, operate, maintain, repair, renew and finally remove an electric line, consisting of **one (1) pole**, together with crossarms, cables, wires, **one (1) anchor**, guys and other fixtures and apparatus thereto belonging, upon, over, under, along, across and through Grantors land, fronting on **Washington Blvd., situate in 11th Wd., City of Pittsburgh, Allegheny County, Pennsylvania, (having tax I.D. 82-H-1-0-2)**, and shown on Duquesne Light Company Drawing No. **478557**, a copy of which has been attached to and made part hereof. Duquesne Light Company shall also have the following rights: to trim or remove any trees or shrubbery which, at any time or times, may interfere or threaten to interfere with the erection, installation, use, operation, maintenance, repair, renewal or removal of the electric line; to enter upon the land at any time for such purposes; to permit others to attach crossarms, cables, wires and related apparatus, and to use the poles and apparatus erected hereunder; and to sell, assign, lease or otherwise transfer any or all of the rights hereunder.

Utility shall file a copy of this Agreement with the Pennsylvania Public Utility Commission as required by Title 66, Section 507 of the Public Utility Code, and this Agreement shall become effective in accordance therewith

Intending to be legally bound the Grantor **has** executed this agreement this 14 day of JUNE, 2019.

CITY OF PITTSBURGH, a municipal corporation of the Commonwealth of Pennsylvania

WITNESS/ATTEST:

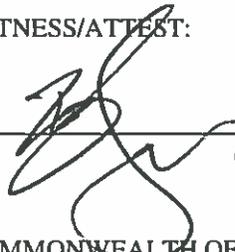

(Assistant) Secretary

By: 


Margaret L. Lanier, Director of Finance

COMMONWEALTH OF PENNSYLVANIA
SS:
COUNTY OF ALLEGHENY


On this 14 day of JUNE, 2019, before me, a Notary Public in and for the Commonwealth and County, personally appeared Margaret L. Lanier, Director of Finance of the City of Pittsburgh, a municipal corporation of the Commonwealth of Pennsylvania, and as such Director, being authorized to do so, executed the foregoing instrument for the purposes therein contained.

WITNESS my hand and seal the day and year aforesaid.

Commonwealth of Pennsylvania - Notary Seal
Amy E. Manfreda, Notary Public
Allegheny County
My commission expires February 19, 2022
Commission number 1281798
Member, Pennsylvania Association of Notaries

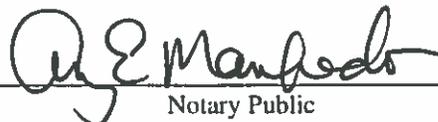

Notary Public

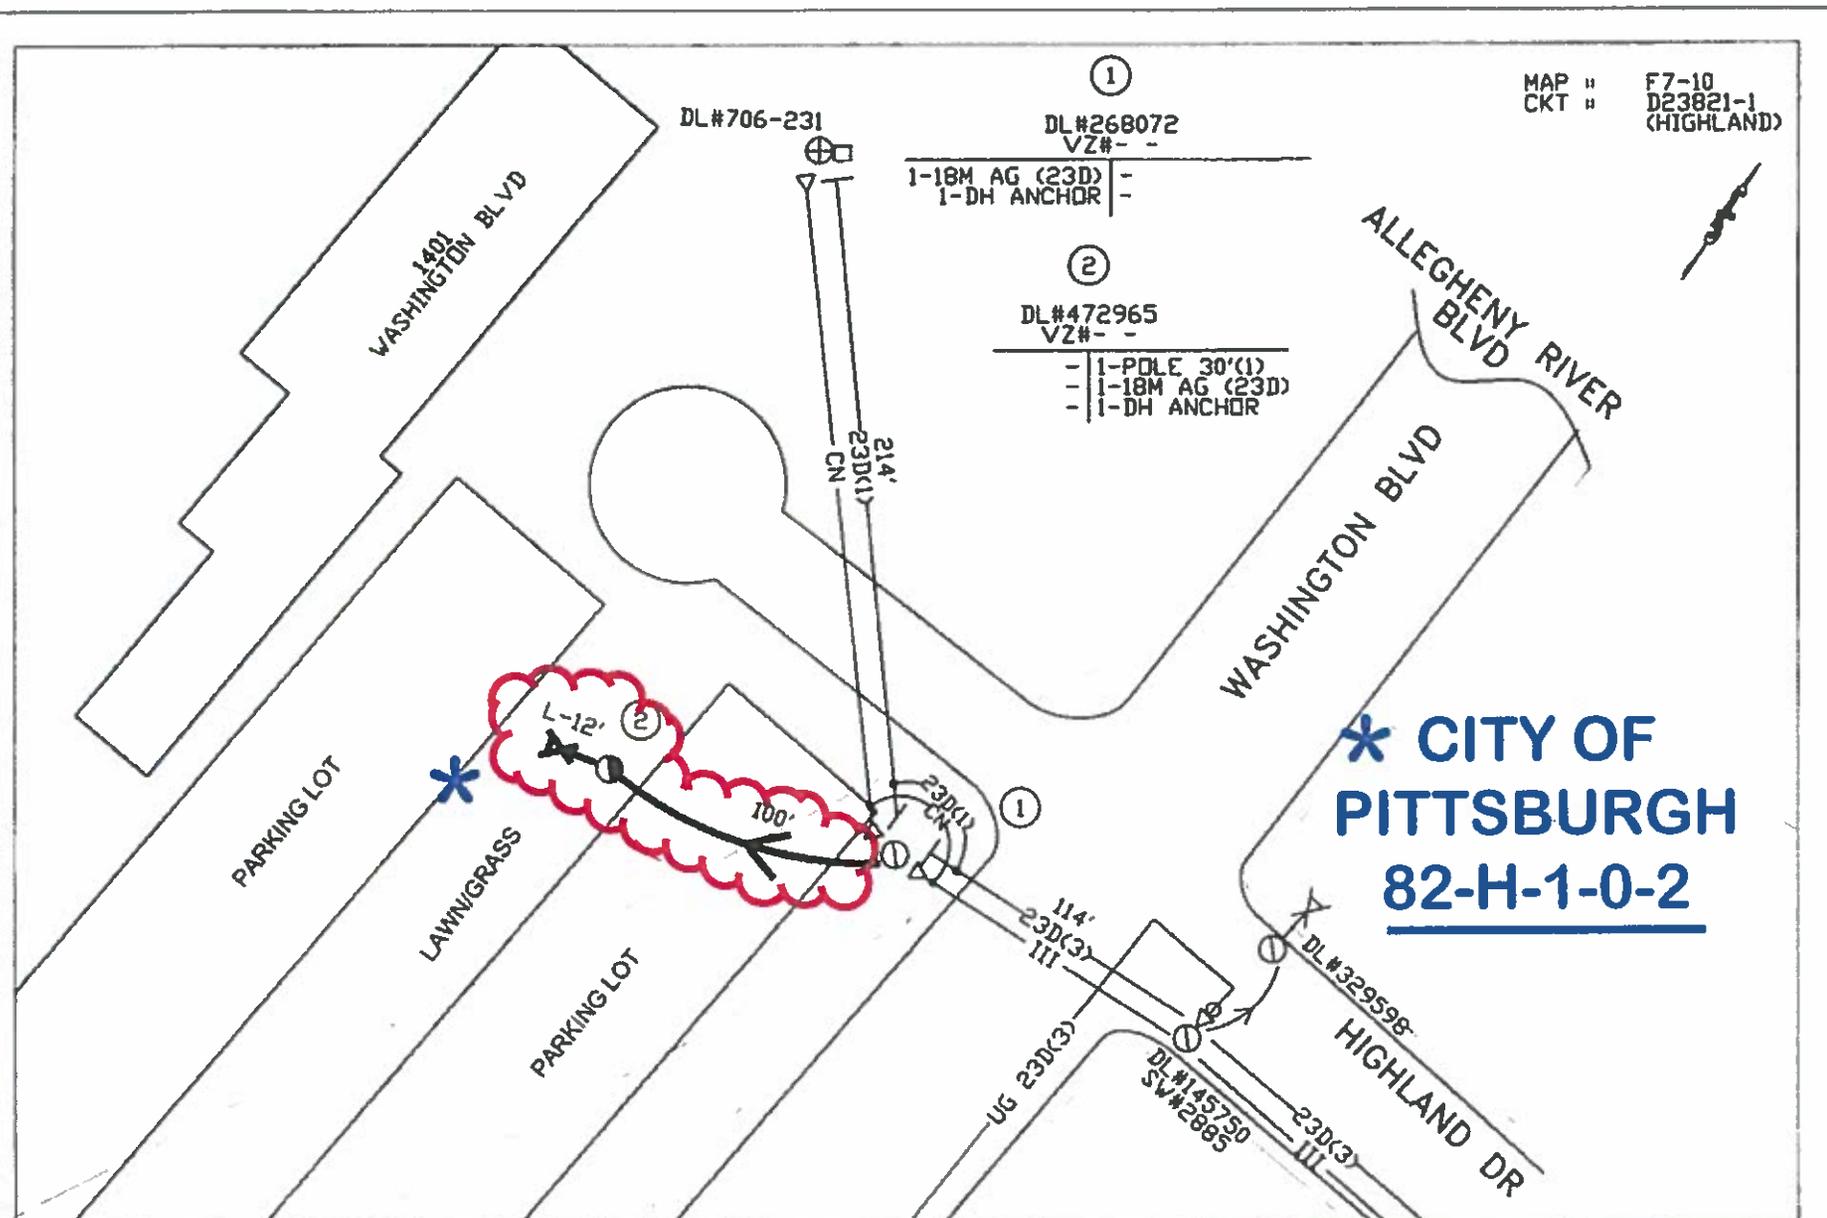

MAP #: F7-10
 CKT #: D23821-1 (HIGHLAND)

①
 DL#268072
 VZ# - -
 1-18M AG (23D) -
 1-DH ANCHOR -

②
 DL#472965
 VZ# - -
 - 1-POLE 30'(1)
 - 1-18M AG (23D)
 - 1-DH ANCHOR

*** CITY OF
 PITTSBURGH
 82-H-1-0-2**

DUQUESNE LIGHT CO. DISTRIBUTION ENGINEERING				GUYING REDESIGN FOR MULTI PURPOSE TRAIL 1401 WASHINGTON BLVD PGH, WARD 11	
AS-BUILT DATE	AS-CONTR. DATE	SCALE	DATE CORR.	DATE	DATE
		NTS	5/1/19	H. MISHRA	5.6.2019
				18-0008	478557

REV. 0