

BEFORE

PENNSYLVANIA PUBLIC UTILITY COMMISSION

In re: Application of PPL Electric Utilities for approval of the alteration of the crossing 591910B by the replacement of one utility pole structure where Paxton St crosses at grade the tracks of Norfolk Southern Railroad, located in Harrisburg in Dauphin County.

Application

Docket No.

To Pennsylvania Public Utility Commission:

1. The name and address of applicant are:

PPL Electric Utilities Corporation

650 Hamilton St - Suite 601

Allentown, PA 18101

2. The name and address of the applicant's attorney are
Mallory Sweeney

645 Hamilton Street, Suite 601, Allentown, PA 18101

mjsweeney@pplweb.com

3. PPL Electric Utilities wishes to replace one existing pole in Harrisburg, Dauphin County, PA. To support existing and future loading conditions. Aerial cables that cross Norfolk Southern Railroad rails within the public right-of-way of Paxton St are to be raised to meet clearance requirements. The above ground communication facilities to be altered are on PPL poles #24499S33719 and #24489S33719.

4. The proposed construction will be the raising of existing power facilities on either side of the railroad crossing and the replacement of an existing anchor. The communication facility will be aerial. Paxton St intersects the railroad at grade. See attached Exhibit "A". The estimated completion date for this project is August 19th, 2024.

5. The public utilities, municipalities, corporations and property owners concerned in, or affected by, the crossing alteration are identified in Exhibit "B" attached hereto

6. The expected cost for the construction procedure is \$10,000. PPL Electric Utilities will pay all costs of construction of the utility pole replacements, In addition to being responsible for installing, maintaining and inspecting the facilities.

7. The alteration is necessary or proper for the following reasons: to provide adequate, efficient, and reasonable communication facilities and power to the public in Dauphin County and surrounding areas.

Wherefore, applicant prays your Honorable Commission to approve the application:

(Signature of Applicant)

§ 1.36. Verification.

(a) Applications, petitions, formal complaints, motions and answers thereto containing an averment of fact not appearing of record in the action or containing a denial of fact shall be personally verified by a party thereto or by an authorized officer of the party if a corporation or association. Verification means a signed written statement of fact supported by oath or affirmation or made subject to the penalties of 18 Pa. C.S. §4904 (relating to unsworn falsification to authorities). If verification is required, notarization is not necessary.

(b) The Verification form should comply substantially with the following:

VERIFICATION

I, Matthew Stutzman, hereby state that the facts above set forth are true and correct (or are true and correct to the best of my knowledge, information and belief) and that I expect to be able to prove the same at a hearing held in this matter. I understand that the statements herein are made subject to the penalties of 18 Pa. C.S. § 4904 (relating to unsworn falsification to authorities).

Date: 5/13/2024

Matthew Stutzman

(Signature)

CERTIFICATE OF SERVICE

I hereby certify that I have this day served a true copy of the foregoing document upon the participants, listed below, in accordance with the requirements of § 1.54 (relating to service by participant) .

Mark Chappel, P.E. - Chief
Bureau of Project Delivery
P.O. Box 3362
Harrisburg, PA 17105-3362
marchappel@pa.gov

DQE Communications LLC
Christopher Smith
424 S 27th Street, Suite 220
Pittsburgh, PA 15203
cssmith@dqe.com

Karen Cummings - Office of Chief Counsel
PennDOT
P.O. Box 8212
Harrisburg, PA 17105-8212
kcummings@pa.gov

CenturyLink
Attn: Engineering/Permitting
100 Centurylink Dr
Monroe, LA 71203
Joe.d.centobene@lumen.com

PennDOT Engineering District
William Warden
2140 Herr St
Harrisburg, PA 17103
Wilwarden@pa.gov

Attn: Engineering/Permits (Caleb Light)
Reed Township Municipal Building
179 Rupp Rd, Halifax, PA 17032
reed.township@yahoo.com

Dauphin County Courthouse
101 Market St
Harrisburg, PA 17101

Norfolk Southern Railroad
Attn: Engineering/Permitting
Three Commercial Place
Norfolk, VA 23510


CTSI-Frontier
Mary Rodman
100 CTE Drive
Dallas, PA 18612

Comcast
Attn: Engineering/Permitting
4601 Smith Street
Harrisburg PA 17109
Mike_Sweigard@comcast.com,
Charles_Orton@comcast.com

Windstream
Jamie Rucker
50 Executive Parkway - Joint Use Department
Hudson, OH 44236-1676

Verizon
Attn: Engineering/Permitting
1026 Hay St
Wilkinsburg, PA 15221
poleconduitadmin1@verizon.com

Dated this 13th day of May, 2024

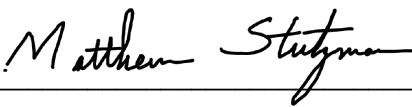

(Signature)

EXHIBIT "B"

The public utilities, municipalities, corporations, and property owners concerned in, or affected by, the crossing alteration are:

Mark Chappel, P.E. - Chief
Bureau of Project Delivery
P.O. Box 3362
Harrisburg, PA 17105-3362
marchappel@pa.gov

Karen Cummings - Office of Chief Counsel
PennDOT
P.O. Box 8212
Harrisburg, PA 17105-8212
kcummings@pa.gov

PennDOT Engineering District
William Warden
2140 Herr St
Harrisburg, PA 17103
Wilwarden@pa.gov

Dauphin County Courthouse
101 Market St
Harrisburg, PA 17101

CTSI-Frontier
Mary Rodman
100 CTE Drive
Dallas, PA 18612

Windstream
Jamie Rucker
50 Executive Parkway - Joint Use Department
Hudson, OH 44236-1676

DQE Communications LLC
Christopher Smith
424 S 27th Street, Suite 220
Pittsburgh, PA 15203
cssmith@dqe.com



CenturyLink
Attn: Engineering/Permitting
100 Centurylink Dr
Monroe, LA 71203
Joe.d.centobene@lumen.com

Attn: Engineering/Permits (Caleb Light)
Reed Township Municipal Building
179 Rupp Rd, Halifax, PA 17032
reed.township@yahoo.com

Norfolk Southern Railroad
Attn: Engineering/Permitting
Three Commercial Place
Norfolk, VA 23510

Comcast
Attn: Engineering/Permitting
4601 Smith Street
Harrisburg PA 17109
Mike_Sweigard@comcast.com,
Charles_Orton@comcast.com

Verizon
Attn: Engineering/Permitting
1026 Hay St
Wilkinsburg, PA 15221
poleconduitadmin1@verizon.com

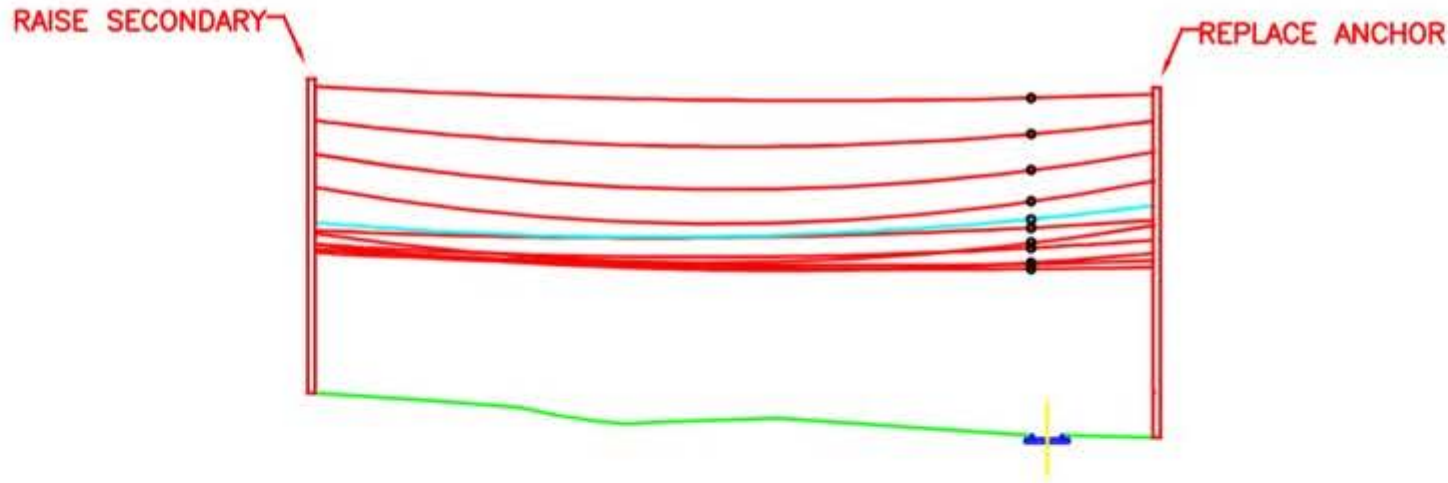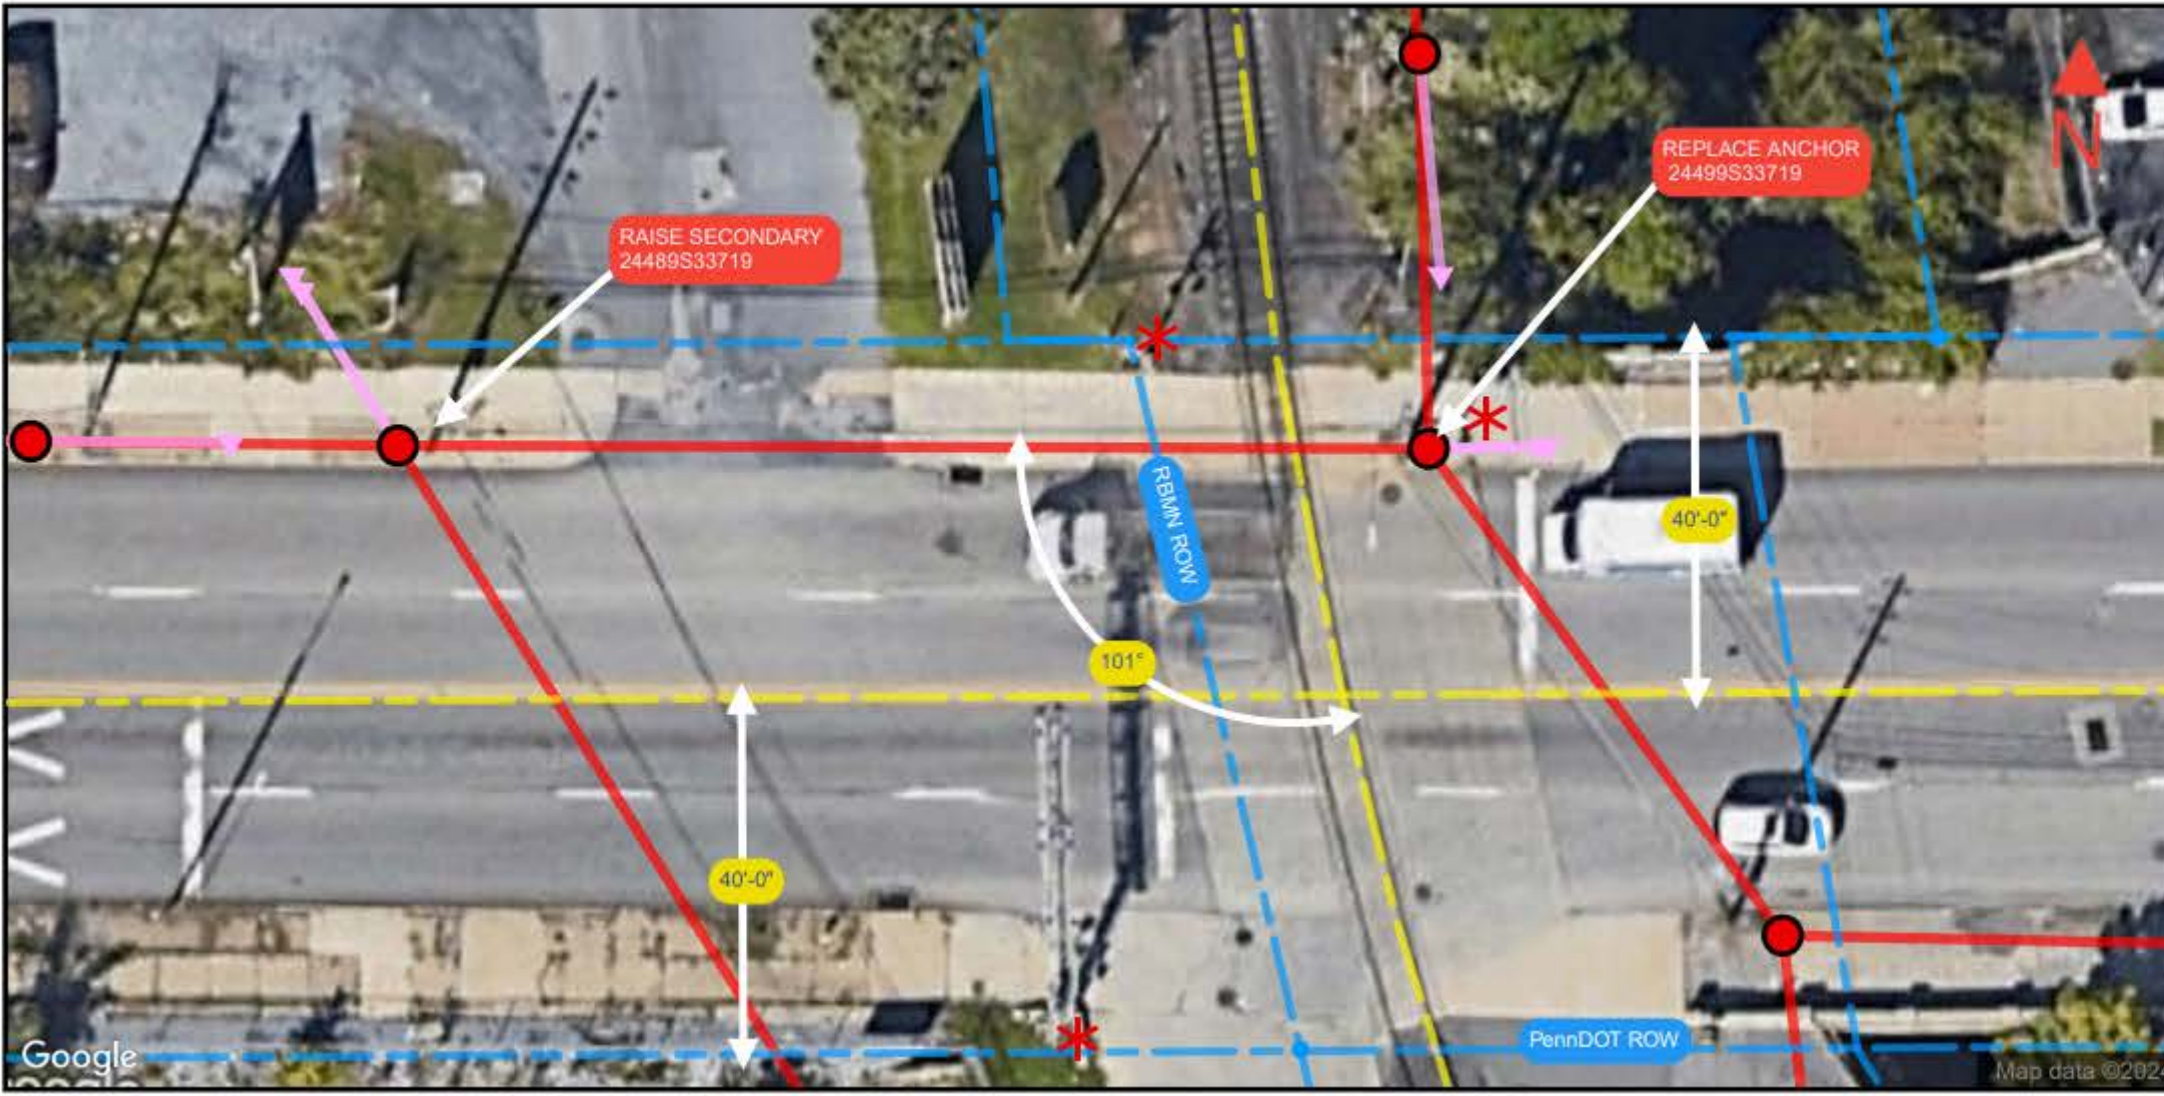


EXISTING HEIGHTS	PROPOSED HEIGHTS
PRIMARY 44'-6"	44'-6"
PRIMARY 40'-3"	40'-3"
PRIMARY 36'-1"	36'-1"
SECONDARY 32'-2"	32'-3"
PROPOSED COM 29'-3"	29'-3"
COM 28'-3"	28'-3"
COM 26'-3"	26'-3"
COM 25'-6"	25'-6"
COM 23'-6"	23'-6"
COM 23'-4"	23'-4"
COM 22'-8"	22'-8"



- Aerial
- RxR Signal
- Center line
- Right of way line
- Pole
- Anchor

ppl
PPL Electric Utilities

TITLE: 306780	REPAIRED BY:		
PROJECT NO:	CITY: Harrisburg		
PRINT NO: 1	COUNTY: Dauphin		
NO. OF PRINTS: 1	STATE: Pennsylvania		
ENGINEERED BY: KATAPULT	DATE: 07-May-2024		
FILENAME: EXHIBIT A		DRAWN BY: EJC	

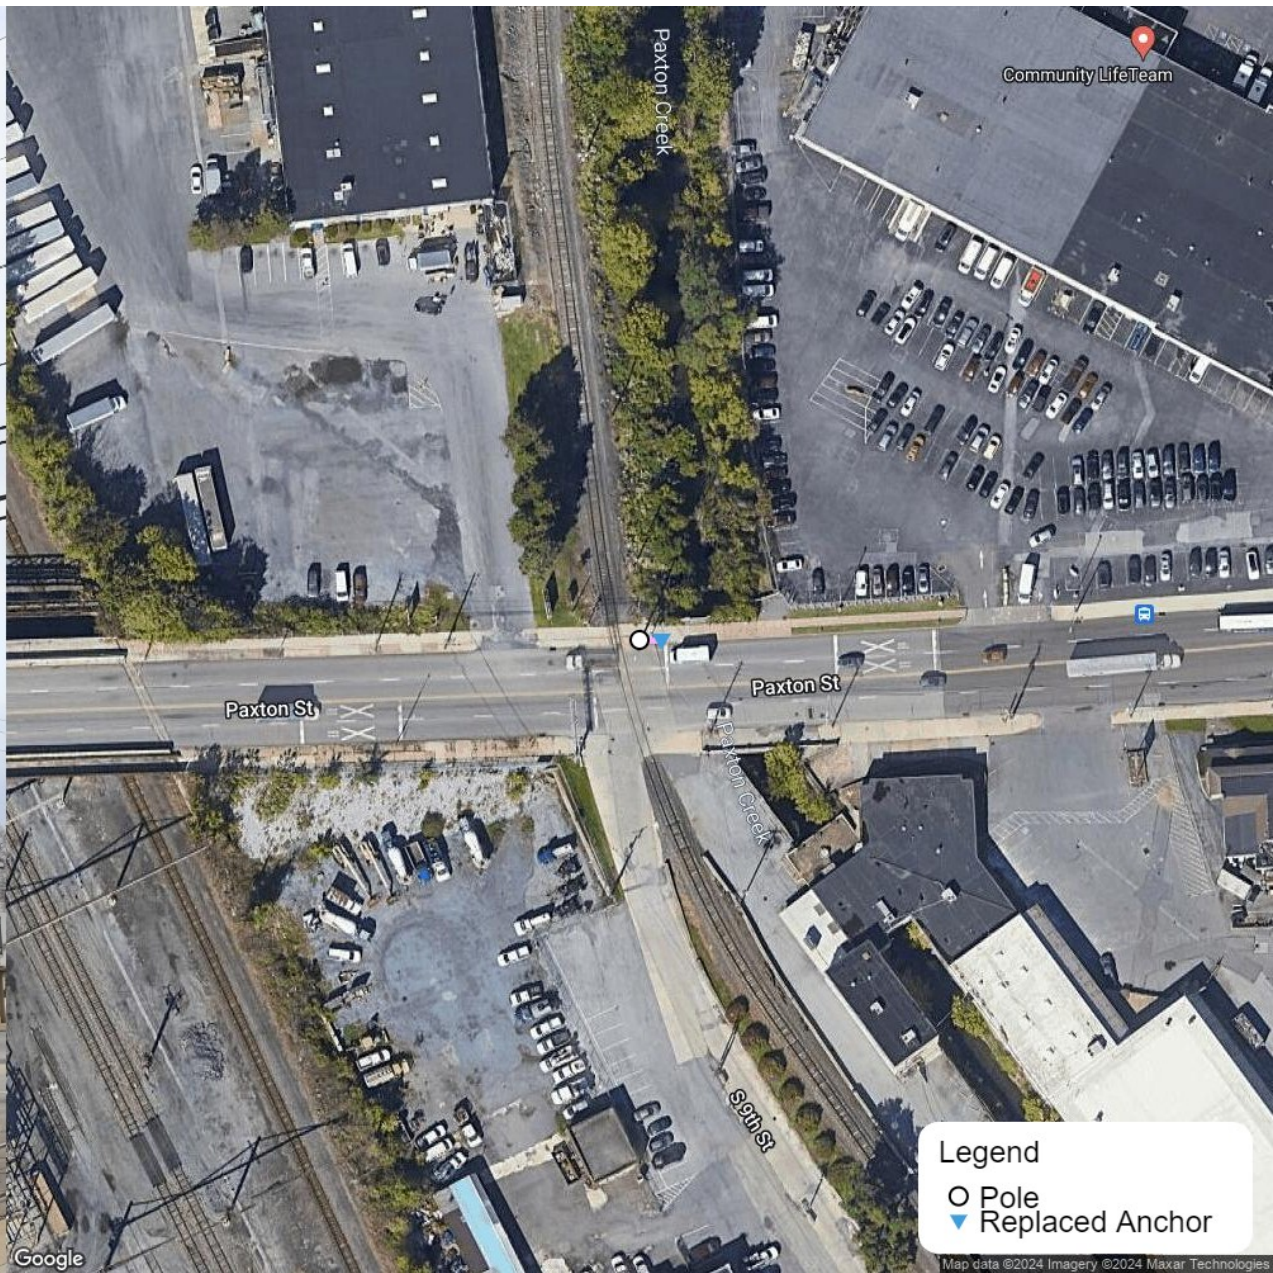

Legend

- Pole
- ▾ Replaced Anchor