

BEFORE

PENNSYLVANIA PUBLIC UTILITY COMMISSION

In re: Application of PPL Electric
Utilities for approval of the alteration
of utility facilities at crossing
851862H where Schoenersville Rd
crosses at grade the tracks of Norfolk
Southern Railroad, located in
Hanover Twp in Northampton County.

Application

Docket No.

To Pennsylvania Public Utility Commission:

1. The name and address of applicant are:

PPL Electric Utilities Corporation

650 Hamilton St - Suite 601

Allentown, PA 18101

2. The name and address of the applicant's attorney are
MALLORY SWEENEY

650 Hamilton St. Suite 601, Allentown PA, 18101

3. PPL Electric Utilities wishes to replace one existing pole in Hanover Twp, Lycoming County, PA. To support existing and future loading conditions. Aerial cables that cross

Norfolk Southern Railroad rails within the public right-of-way of Schoenersville Rd are to be raised to meet clearance requirements. The above ground communication facilities to be altered are on PPL pole #65521S48223.

4. The proposed construction will be the raising of existing power facilities across the railroad crossing and the replacement of an existing anchor. The communication facility will be aerial. Schoenersville Rd intersects the railroad at grade. See attached Exhibit "A". The estimated completion date for this project is November 12th, 2024.

5. The public utilities, municipalities, corporations and property owners concerned in, or affected by, the crossing alteration are identified in Exhibit "B" attached hereto

6. The expected cost for the construction procedure is \$10,000. PPL Electric Utilities will pay all costs of construction of the utility pole replacements, In addition to being responsible for installing, maintaining and inspecting the facilities.

7. The alteration is necessary or proper for the following reasons: to provide adequate, efficient, and reasonable communication facilities and power to the public in Lycoming County and surrounding areas.

Wherefore, applicant prays your Honorable Commission to approve the application:

(Signature of Applicant)

§ 1.36. Verification.

(a) Applications, petitions, formal complaints, motions and answers thereto containing an averment of fact not appearing of record in the action or containing a denial of fact shall be personally verified by a party thereto or by an authorized officer of the party if a corporation or association. Verification means a signed written statement of fact supported by oath or affirmation or made subject to the penalties of 18 Pa. C.S. §4904 (relating to unsworn falsification to authorities). If verification is required, notarization is not necessary.

(b) The Verification form should comply substantially with the following:

VERIFICATION

I, John Shattah, hereby state that the facts above set forth are true and correct (or are true and correct to the best of my knowledge, information and belief) and that I expect to be able to prove the same at a hearing held in this matter. I understand that the statements herein are made subject to the penalties of 18 Pa. C.S. § 4904 (relating to unsworn falsification to authorities).

Date: 04/14/2025

John Shattah
(Signature)

CERTIFICATE OF SERVICE

I hereby certify that I have this day served a true copy of the foregoing document upon the participants, listed below, in accordance with the requirements of § 1.54 (relating to service by participant) .

Mark Chappel, P.E. - Chief
Bureau of Project Delivery
P.O. Box 3362
Harrisburg, PA 17105-3362
marchappel@pa.gov

RCN
Attn: Engineering/Permitting
5508 Norbath Blvd
Northampton, PA 18067
kevin.cochran@astound.com

Karen Cummings - Office of Chief Counsel
PennDOT
P.O. Box 8212
Harrisburg, PA 17105-8212
kcummings@pa.gov

Northampton County Courthouse
669 Washington St
Easton, PA 18402

PennDOT Engineering District 5
1002 Hamilton St
Allentown, PA 18101
mhaddad@pa.gov

Norfolk Southern Railroad
Attn: Engineering/Permitting
Three Commercial Place
Norfolk, VA 23510

Level 3 Fiber Optic Communications
1025 Eldorado Boulevard
Broomfield Colorado 80021
paul.erickson@lumen.com

Service Electric Cable TV Inc.
Attn: Engineering/Permitting
2260 Ave A. LVIP #1
Allentown, PA 18017
dianer@sectv.com

XO Fiber Optic Communications
Attn: Engineering/Permitting
13865 Sunrise Valley Dr
Herndon, VA 20171

Metropolitan Fiber Systems C/O MCI
ATTN: Patty McMurray - D3
2400 N. Glenville Drive
Richardson, TX 75082
(Patty.mcmurray@verizonbusiness.com)

City of Bethlehem
Department of Public Works
10 E. Church Street
Bethlehem, PA 18018

Dated this 14th day of April, 2025



(Signature)

EXHIBIT "B"

The public utilities, municipalities, corporations, and property owners concerned in, or affected by, the crossing alteration are:

Mark Chappel, P.E. - Chief
Bureau of Project Delivery
P.O. Box 3362
Harrisburg, PA 17105-3362
marchappel@pa.gov

Karen Cummings - Office of Chief Counsel
PennDOT
P.O. Box 8212
Harrisburg, PA 17105-8212
kcummings@pa.gov

PennDOT Engineering District 5
1002 Hamilton St
Allentown, PA 18101
mhaddad@pa.gov

Level 3 Fiber Optic Communications
1025 Eldorado Boulevard
Broomfield Colorado 80021
paul.erickson@lumen.com

XO Fiber Optic Communications
Attn: Engineering/Permitting
13865 Sunrise Valley Dr
Herndon, VA 20171

City of Bethlehem
Department of Public Works
10 E. Church Street
Bethlehem, PA 18018


RCN
Attn: Engineering/Permitting
5508 Norbath Blvd
Northampton, PA 18067
kevin.cochran@astound.com

Northampton County Courthouse
669 Washington St
Easton, PA 18402

Norfolk Southern Railroad
Attn: Engineering/Permitting
Three Commercial Place
Norfolk, VA 23510


Service Electric Cable TV Inc.
Attn: Engineering/Permitting
2260 Ave A. LVIP #1
Allentown, PA 18017
dianer@sectv.com

Metropolitan Fiber Systems C/O MCI
ATTN: Patty McMurray - D3
2400 N. Glenville Drive
Richardson, TX 75082
(Patty.mcmurray@verizonbusiness.com)

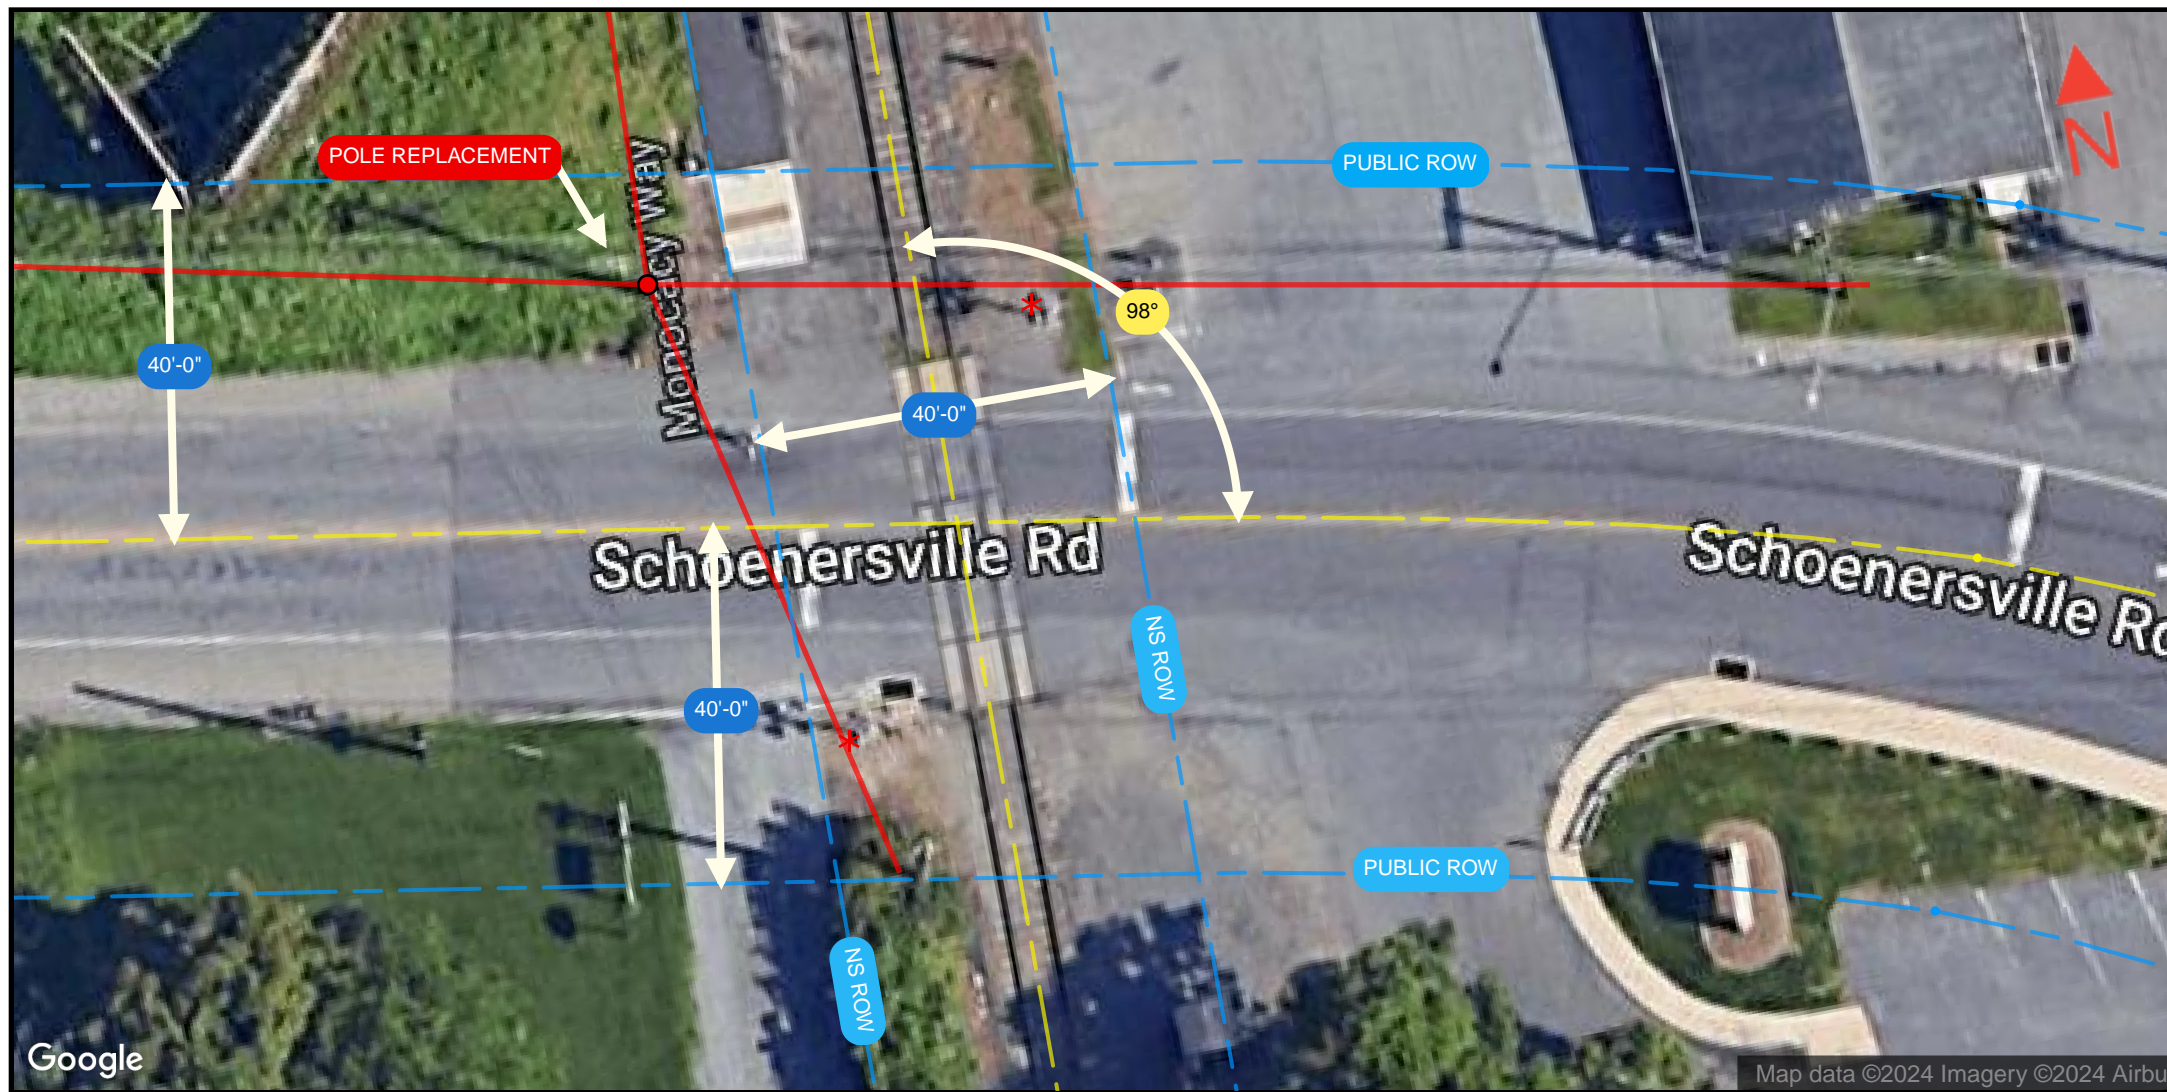


Google

Map data ©2024 Imagery ©2024 Airbus

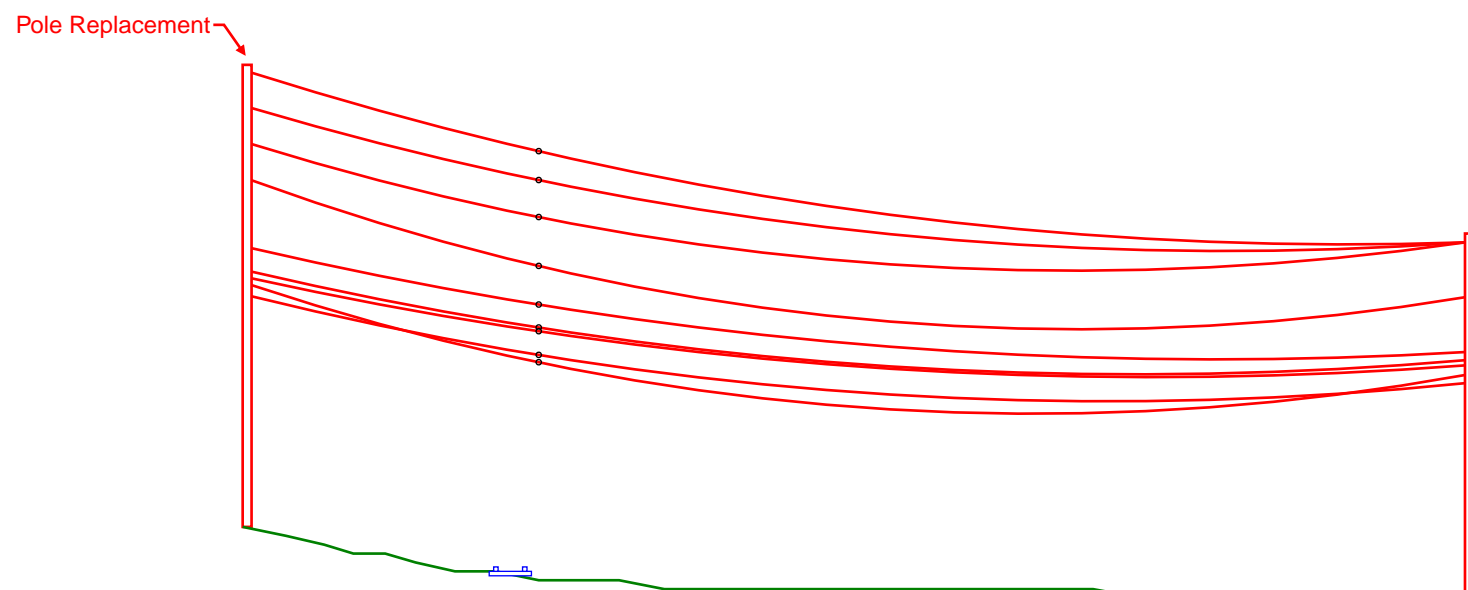


CABLES	WIRE SPEC	EXISTING PROPOSED	
		EXISTING	PROPOSED
Primary	4/0 ACSR (6/1)	45'-10"	48'-3"
Primary	4/0 ACSR (6/1)	42'-11"	45'-0"
Primary	4/0 ACSR (6/1)	39'-0"	40'-10"
Secondary	4/0 TPLX SECD (6/1)	32'-7"	35'-4"
Fiber Optic Com		31'-0"	31'-0"
Fiber Optic Com		28'-5"	28'-5"
Fiber Optic Com		28'-0"	28'-0"
CATV Com		25'-4"	25'-4"
CATV Com		24'-6"	24'-6"

SCALE IN FEET

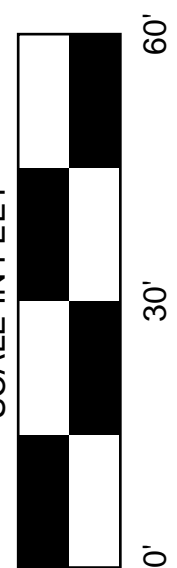

- Right Of Way Line
- Centerline
- Aerial
- RxR Signal
- Existing Anchor
- New Anchor



TOWNSHIP: Hanover	PREPARED BY:			
COUNTY: Northampton				
STATE: Pennsylvania				
DATE: 28-Jul-2024	NO. OF PRINTS: 1	ENGINEERED BY: KATAPULT	FILENAME:	EXHIBIT A
DRAWN BY: STEM				

