A-2023-3041540

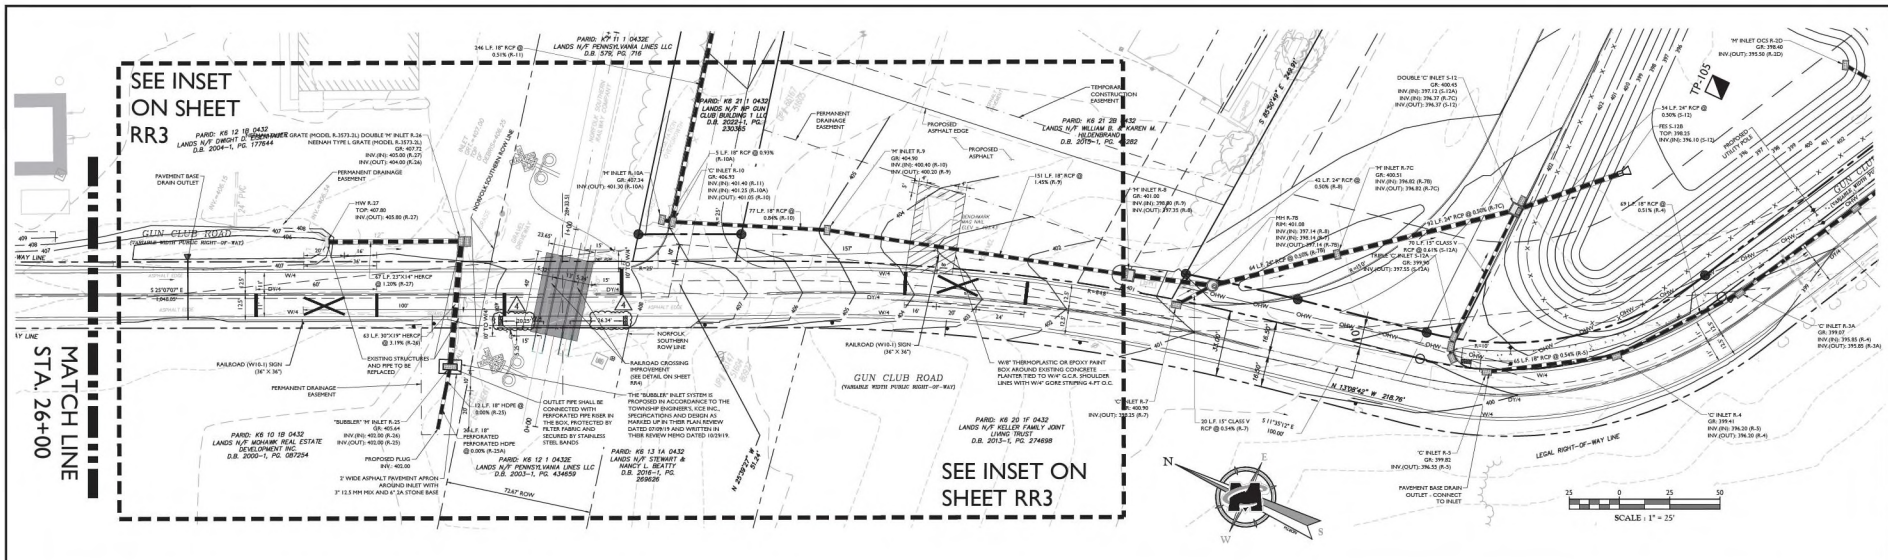

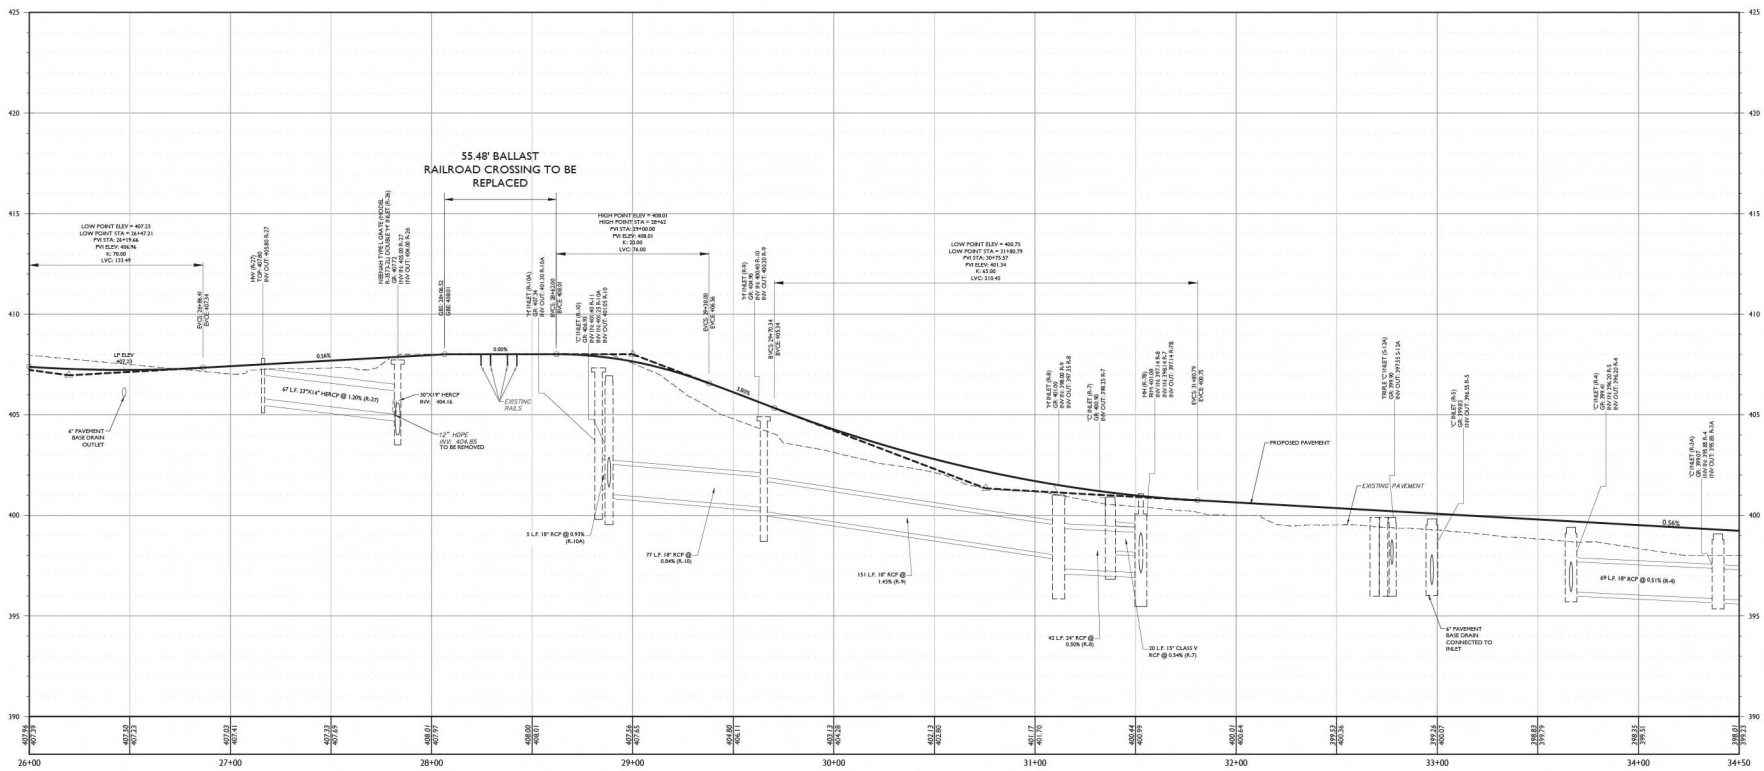

PROFILE OF GUN CLUB ROAD
HORIZONTAL : 1" = 25'
VERTICAL : 1" = 2.5'

CERTIFIED CORRECT PLANS
Professional Engineer
Bureau of Technical Utility Services
PA PUBLIC UTILITY COMMISSION
ATTEST
Secretary

NOTE: ONLY NORFOLK-SOUTHERN RAILROAD ROAD SIGNS ARE SHOWN ON THIS PLAN. ALL OTHER SIGNS ARE LISTED ON OTHER PLANS.

MASER CONSULTING
WELL BE KNOWN AS COLLERS ENGINEERING & DESIGN PA DBA
Customer Loyalty through Client Satisfaction
www.maserconsulting.com
Office Locations:
NEW JERSEY · NEW YORK · PENNSYLVANIA · VIRGINIA · FLORIDA · NORTH CAROLINA · SOUTH CAROLINA · NEW MEXICO · MARYLAND · GEORGIA · TEXAS · TENNESSEE · COLORADO

Copyright © 2016, Maser Consulting. All Rights Reserved. The drawing and all the information contained herein is authorized for use only by the party for whom it was prepared and for the purpose for which it is certified. This drawing may not be copied, reused, disclosed, distributed or relied upon for any other purpose without the express written consent of Maser Consulting.

811 PROTECT YOURSELF
ALL STATES REQUIRE NOTIFICATION OF UNDERGROUND UTILITIES BEFORE BEGINNING TO DETERMINE MARKING SERVICE NATIONWIDE 811 STATE
Know what's below. Call before you dig.
2015197063
FOR STATE SPECIFIC DIRECT PHONE NUMBERS VISIT: WWW.CALL811.COM

REV	DATE	DRAWN BY	DESCRIPTION

REV	DATE	DRAWN BY	DESCRIPTION
1	4/4/23	MQ	REVISED TO NORFOLK SOUTHERN REVIEW COMMENTS DATED 1/31/23 (RR1)
2	5/31/23	MQ	REVISED TO 100 YR ASPHALT CLEARANCE (RR1)
3	8/11/23	MQ	REVISED TO NORFOLK SOUTHERN REVIEW COMMENTS DATED 8/08/2023
4	1/11/24	JPP	REVISED LOCATION OF SIGNS

COMMONWEALTH OF PENNSYLVANIA REGISTERED PROFESSIONAL ENGINEER C. RICHARD ROSEBERRY No. 46192
C. Richard Roseberry
PENNSYLVANIA REGISTERED PROFESSIONAL ENGINEER
LICENSE NUMBER: PE046192R
COLLERS ENGINEERING & DESIGN, INC.

PROPOSED WIDENING AND RESURFACING OF GUN CLUB ROAD EXISTING RAILROAD CROSSING FOR
UPPER NAZARETH TOWNSHIP

UPPER NAZARETH TOWNSHIP
NORTHAMPTON COUNTY
PENNSYLVANIA

LEHIGH VALLEY OFFICE
941 Marcon Boulevard
Suite 801
Allentown, PA 18109
Phone: 610.868.4201
Fax: 610.264.4672

SCALE:	DATE:	DRAWN BY:	CHECKED BY:
AS SHOWN	7/20/2023	MQ	NMQ

PROJECT NUMBER: 180000458 · DRAWING NAME: C.RAIL

SHEET TITLE: PLAN AND PROFILE

SHEET NUMBER: RR2 of RR4

NOTE: DO NOT SCALE DRAWINGS FOR CONSTRUCTION.

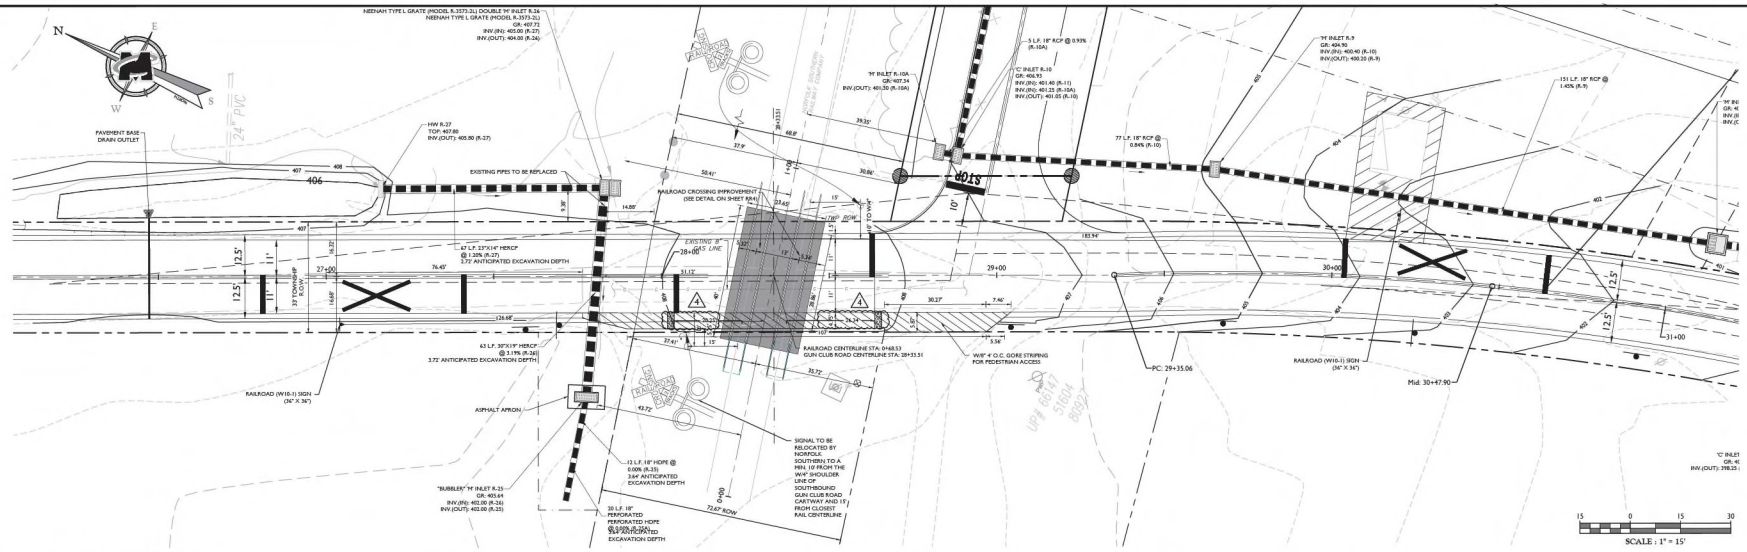

NOTE:ONLY NORFOLK-SOUTHERN RAILROAD ROAD SIGNS ARE SHOWN ON THIS PLAN. ALL OTHER SIGNS ARE LISTED ON OTHER PLANS.

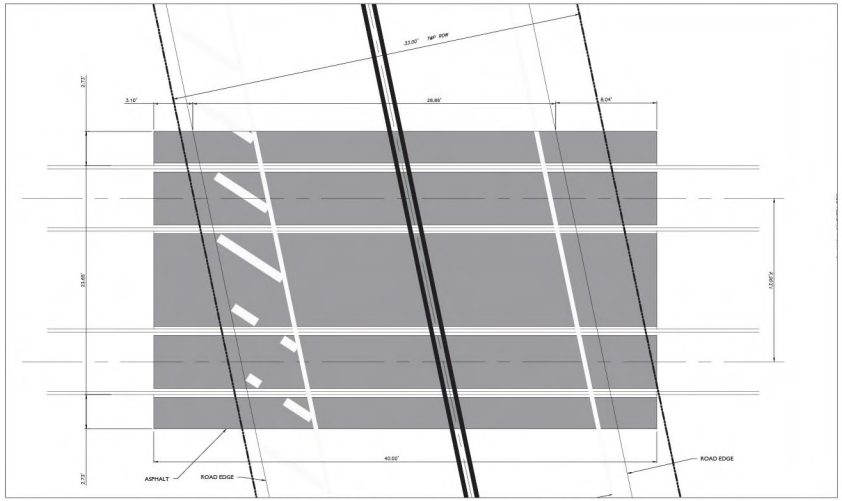

ASPHALT PAVEMENT LAYOUT PLAN FOR RAILROAD CROSSING
SCALE : 1" = 4'

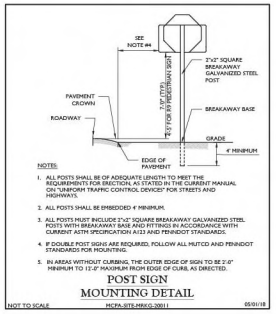

W10-1

RAILROAD WARNING SIGN

(a) Justification. The Railroad Warning Sign (W10-1) may be used in advance of railroad crossings where an intersection is not located within 100' in advance of the railroad crossing.

(b) Placement. The W10-1 sign shall be placed not less than 100' in advance of the crossing but may be placed a greater distance because of roadway alignment or prevailing speeds. If a Yield Ahead (W3-2) or Stop Ahead (W3-1) sign is installed on the approach to the crossing, the W10-1 sign shall be installed upstream from the W3-2 or W3-1 sign.

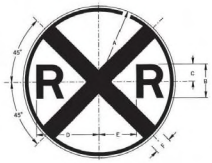

SIGN SIZE	A	B	C	D	E	F	MARGIN	BORDER	BLANK STD.
	DIMENSIONS – IN								
24" DIA.	12	5E	2.5	9.2	5.8	2.5	0.4	0.6	
36" DIA.	18	8E	4	14.4	8.6	4	0.5	0.8	R4-36
48" DIA.	24	10E	5	18.4	11.6	5	0.8	1.2	——

COLOR:

LEGEND, SYMBOL, AND BORDER: BLACK (NON-REFLECTORIZED)

BACKGROUND: YELLOW (REFLECTORIZED)

APPROVED FOR THE SECRETARY OF TRANSPORTATION
By: Date: 02-29-12
Chief, Traffic Engineering and Permits Section
Bureau of Maintenance and Operations

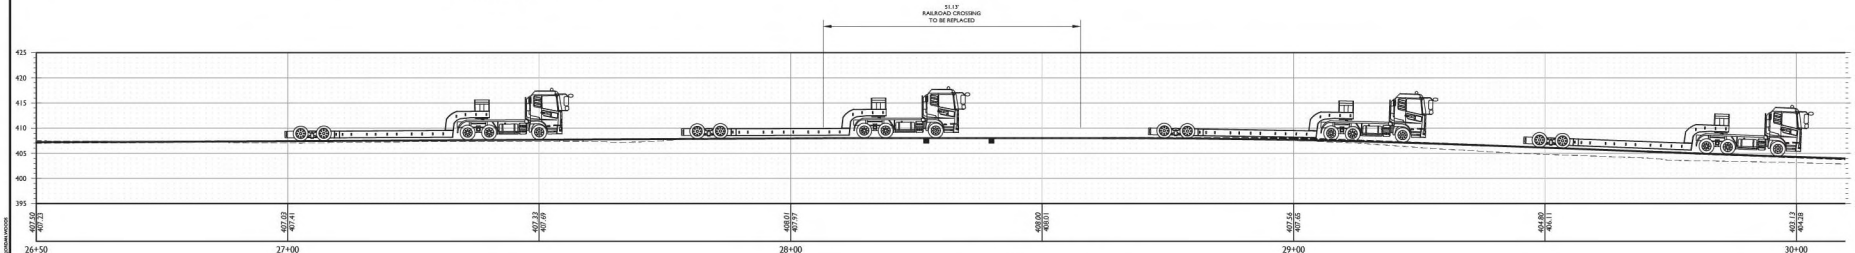

PROFILE OF GUN CLUB ROAD
HORIZONTAL : 1" = 10"
VERTICAL : 1" = 10"

NOTE: DO NOT SCALE DRAWINGS FOR CONSTRUCTION.

MASER CONSULTING
WELL BE KNOWN AS COLLERS ENGINEERING & DESIGN IN 2011
Customer Loyalty through Client Satisfaction
www.maserconsulting.com
Office Locations:
NEW JERSEY · NEW YORK · PENNSYLVANIA · VIRGINIA · FLORIDA · NORTH CAROLINA · SOUTH CAROLINA · NEW MEXICO · MARYLAND · GEORGIA · TEXAS · TENNESSEE · COLORADO

Copyright © 2006. Maser Consulting. All Rights Reserved. The reuse and all the information contained herein is authorized for the original site and purpose for which it was prepared and for which it is certified. This drawing may not be copied, reused, disclosed, distributed or relied upon for any other purpose without the express written consent of Maser Consulting.

811 PROTECT YOURSELF
Know what's below. Call before you dig.
FOR STATE SPECIFIC DIRECT PHONE NUMBERS VISIT: WWW.CALL811.COM

REV	DATE	DRAWN BY	DESCRIPTION

REV	DATE	DRAWN BY	DESCRIPTION

C. RICHARD ROSEBERRY
REGISTERED PROFESSIONAL ENGINEER
C. Richard Roseberry
PENNSYLVANIA REGISTERED PROFESSIONAL ENGINEER
COLLERS ENGINEERING & DESIGN, INC.

PROPOSED WIDENING AND RESURFACING OF GUN CLUB ROAD EXISTING RAILROAD CROSSING FOR UPPER NAZARETH TOWNSHIP

UPPER NAZARETH TOWNSHIP
NORTHAMPTON COUNTY
PENNSYLVANIA

LEHIGH VALLEY OFFICE
941 Marcon Boulevard
Suite 801
Allentown, PA 18109
Phone: 610.868.4201
Fax: 610.264.4672

SCALE:	DATE:	DRAWN BY:	CHECKED BY:

DRAWING NAME: C.RAIL

SHEET TITLE: PLAN AND PROFILE

SHEET NUMBER: RR3 of RR4